




NOTES:
 1. DOOR REFERENCES ONLY SHOWN ON NEW DOORS.
 2. WINDOW REFERENCES ONLY SHOWN ON NEW WINDOWS.

LEGEND:

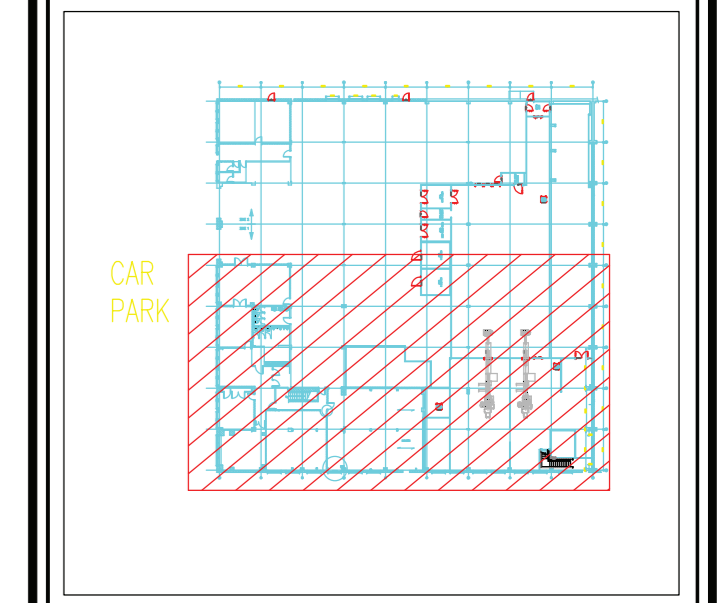

SITE KEY

DRAWING STATUS
AS INSTALLED

REV	DATE	BY	DESCRIPTION